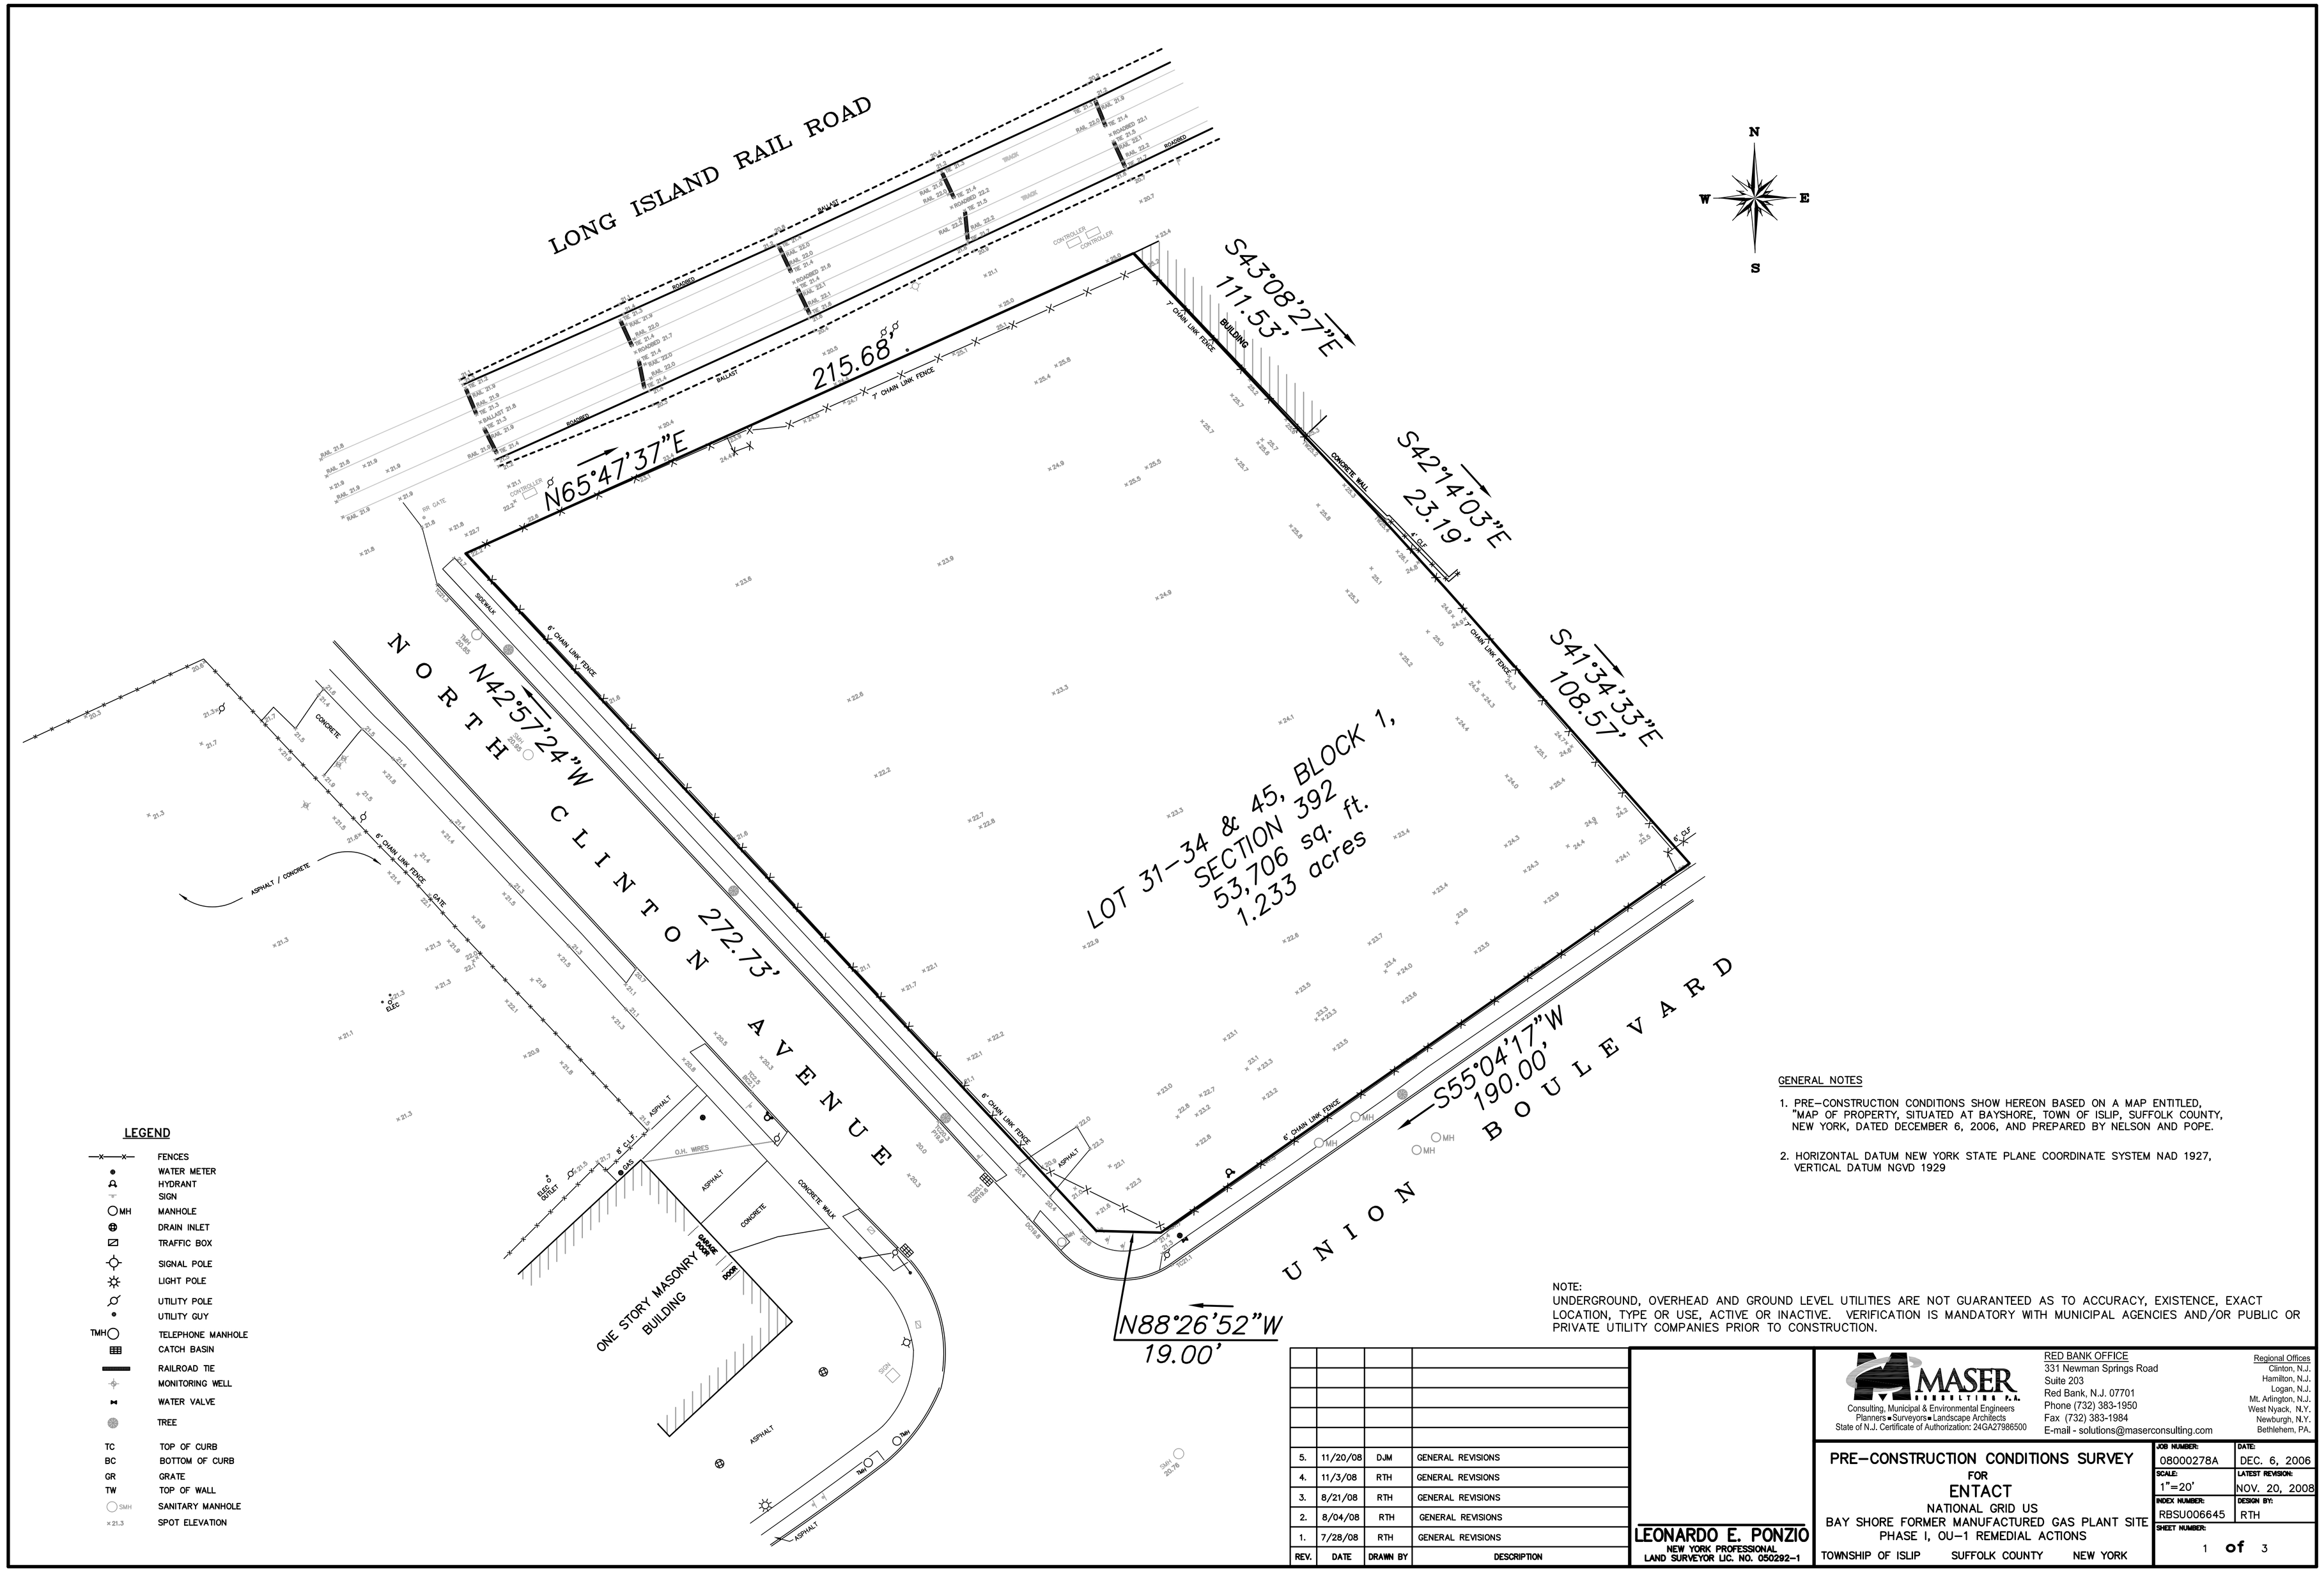

GENERAL NOTES

1. PRE-CONSTRUCTION CONDITIONS SHOW HEREON BASED ON A MAP ENTITLED, "MAP OF PROPERTY, SITUATED AT BAYSHORE, TOWN OF ISLIP, SUFFOLK COUNTY, NEW YORK, DATED DECEMBER 6, 2006, AND PREPARED BY NELSON AND POPE.

2. HORIZONTAL DATUM NEW YORK STATE PLANE COORDINATE SYSTEM NAD 1927, VERTICAL DATUM NGVD 1929

NOTE:
UNDERGROUND, OVERHEAD AND GROUND LEVEL UTILITIES ARE NOT GUARANTEED AS TO ACCURACY, EXISTENCE, EXACT LOCATION, TYPE OR USE, ACTIVE OR INACTIVE. VERIFICATION IS MANDATORY WITH MUNICIPAL AGENCIES AND/OR PUBLIC OR PRIVATE UTILITY COMPANIES PRIOR TO CONSTRUCTION.

REV.	DATE	DRAWN BY	DESCRIPTION
5.	11/20/08	DJM	GENERAL REVISIONS
4.	11/3/08	RTH	GENERAL REVISIONS
3.	8/21/08	RTH	GENERAL REVISIONS
2.	8/04/08	RTH	GENERAL REVISIONS
1.	7/28/08	RTH	GENERAL REVISIONS

LEONARDO E. PONZIO
NEW YORK PROFESSIONAL
LAND SURVEYOR LIC. NO. 050292-1

MASER CONSULTING P.A.
Consulting, Municipal & Environmental Engineers
Planners • Surveyors • Landscape Architects
State of N.J. Certificate of Authorization: 24GA27986500

RED BANK OFFICE
331 Newman Springs Road
Suite 203
Red Bank, N.J. 07701
Phone (732) 383-1950
Fax (732) 383-1984
E-mail - solutions@maserconsulting.com

Regional Offices
Clinton, N.J.
Hamilton, N.J.
Logan, N.J.
Mt. Arlington, N.J.
West Nyack, N.Y.
Newburgh, N.Y.
Bethlehem, PA.

PRE-CONSTRUCTION CONDITIONS SURVEY
FOR
ENTACT
NATIONAL GRID US
BAY SHORE FORMER MANUFACTURED GAS PLANT SITE
PHASE I, OU-1 REMEDIAL ACTIONS
TOWNSHIP OF ISLIP SUFFOLK COUNTY NEW YORK

JOB NUMBER: 08000278A	DATE: DEC. 6, 2006
SCALE: 1"=20'	LATEST REVISION: NOV. 20, 2008
INDEX NUMBER: RBSU006645	DESIGN BY: RTH
SHEET NUMBER: 1 of 3	